


Plot Date:	June 2, 2014
Time:	12:15 AM
File Size:	0.63
Login:	William Velez

Rev.	Date	Comments

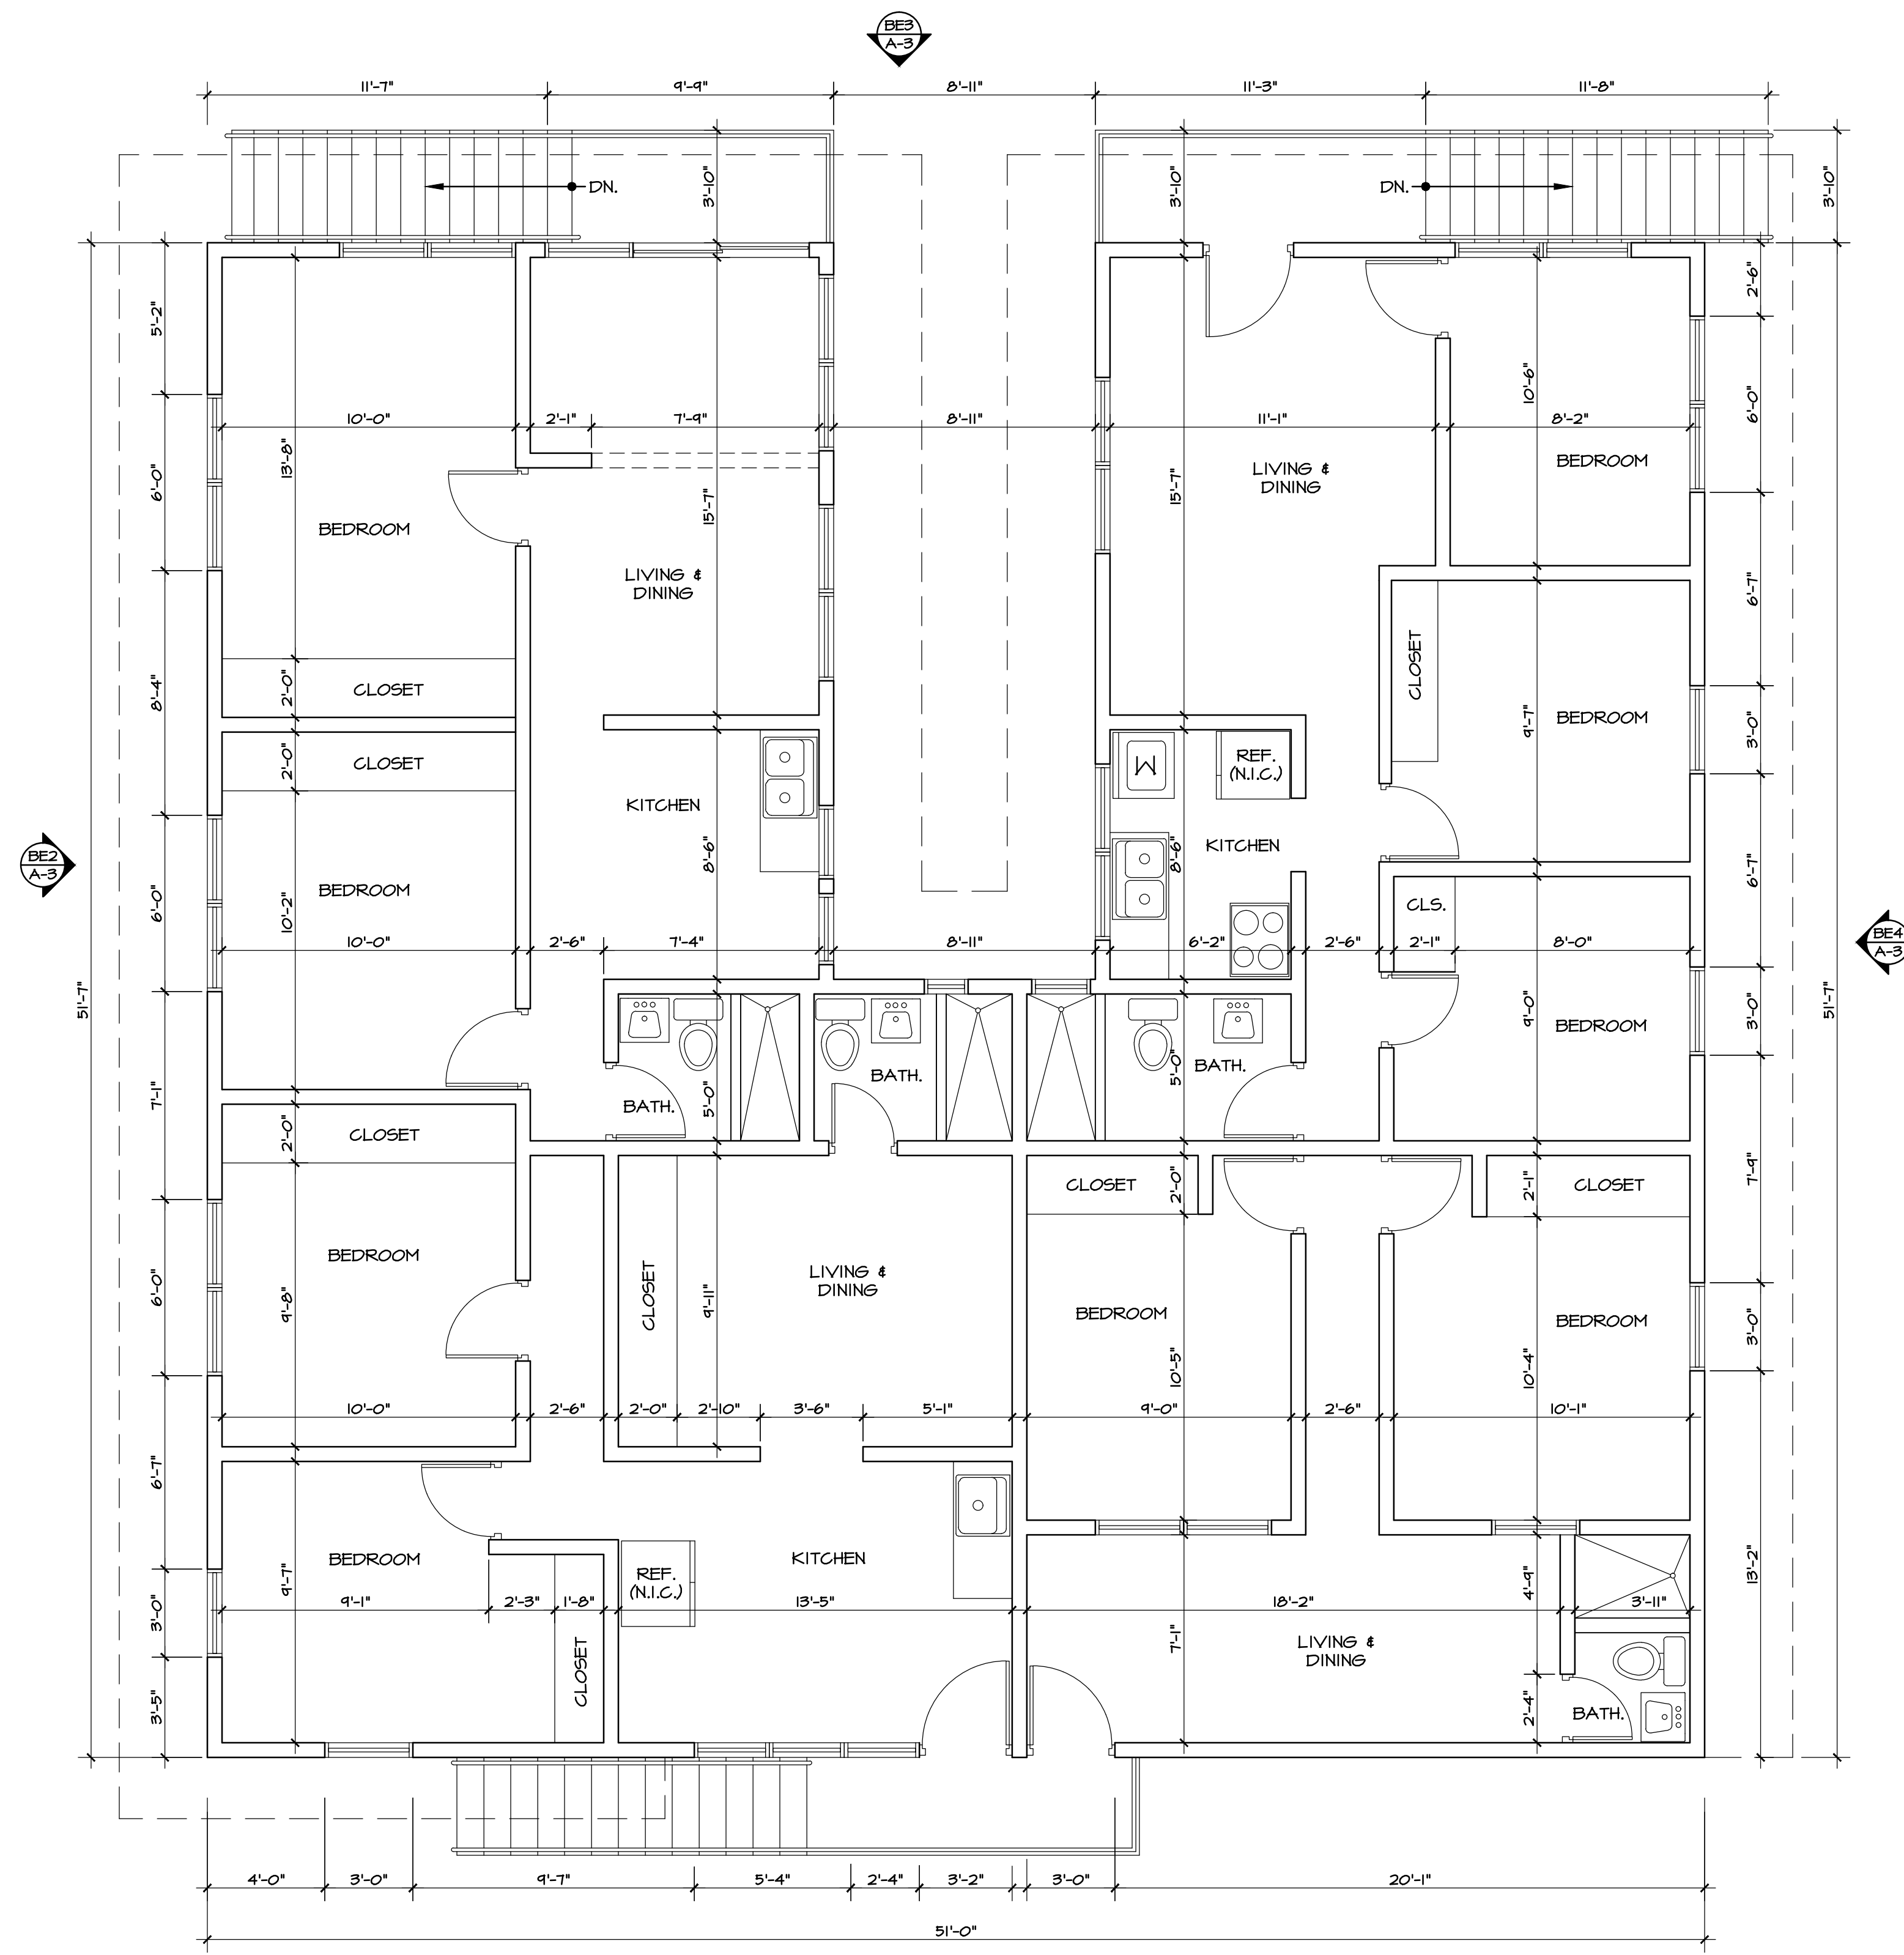

**AS-BUILT SECOND FLOOR PLAN**  
 SCALE: 1/4"=1'-0"

**As-Built Second Floor Plan**  
**RUF, LLC**  
 Calle Dunquerque 615, Puerto Nuevo, San Juan, P.R.

Title Sheet  
 Project Name  
 Project Location

Certified By:

Drawing No.  
**AB-2**